

M/035/011

Kennecott Utah Copper Corporation
8315 West 3595 South
P.O. Box 6001
Magna, Utah 84044-6001
(801) 252-3000

Kennecott

October 22, 2003

Mr. D Wayne Hedberg
Minerals Reclamation Program
Division of Oil, Gas and Mining
1594 West North Temple, Suite 1210
Salt Lake City, Utah

Subject: Information for Five-Year Review of Reclamation Surety Estimate for
Kennecott Utah Copper Corporation, Copperton Concentrator and 4th Line
Expansion, M/035/011, Salt Lake County, Utah


Dear Mr. Hedberg:

Enclosed please find two maps (Figure 1 and 2) to assist with the five-year review of the surety estimate for the Copperton Concentrator and 4th Line Expansion. Figure 1 shows current surface facilities, including roads, the process water reservoir, processing buildings, copper and copper/molybdenum thickeners, clarifier, copper thickener, ore stockpile (A-frame), tailings thickeners, retention ponds. Over the past five years there have been no new surface disturbances at the Copperton Concentrator apart for the construction of the temporary ore stockpile in 2002.

As stated in a letter sent to the Division of Oil, Gas and Mining on March 22, 2002, to ensure continuous operation of the Copperton Concentrator during the relocation of the primary crusher in the Bingham Canyon Open Pit, a temporary ore stockpile was constructed. The stockpile was located immediately west of the existing ore stockpile at the Copperton Concentrator during April through August 2002. The ore stockpile footprint was approximately 9 acres and was reclaimed in fall 2002 (Figure 2). Stockpiled topsoil was applied to the surface, which was subsequently ripped and hydro-seeded with a native seed mix (Table 1).

Please do not hesitate to contact me at 569-7120 if you have any questions or concerns.

Sincerely,

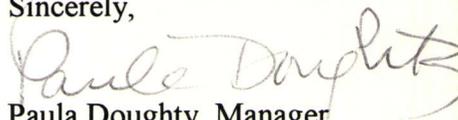

Paula Doughty, Manager
Environmental Affairs and
Strategic Resources

RECEIVED

OCT 22 2003

DIV. OF OIL, GAS & MINING


bcc: Charlie Wilmot
Vicky Peacey

FILE: OPS-RR-MF-DOGM-Corres.


COMMON NAME
Grasses
Kentucky Bluegrass
Squirreltail
Sheep Fescue
Great Basin Wildrye
Slender Wheatgrass
Western Wheatgrass
Bluebunch Wheatgrass
Mountain Brome
Legumes
Wild Lupine
Mountain Lupine
American Vetch
Forbs
Milfoil Yarrow
Small Burnett
Wasach Penstemon
Rocky Mountain Penstemon
Prairie Aster
Iceland Poppy
Trees/Shrubs
Rubber Rabbitbrush
Mountain Big Sage
Curl Leaf Mountain Mahogany

Table 1. Copperton Concentrator Temporary Ore Stockpile Seed Mix for Fall 2002.

M/035/019

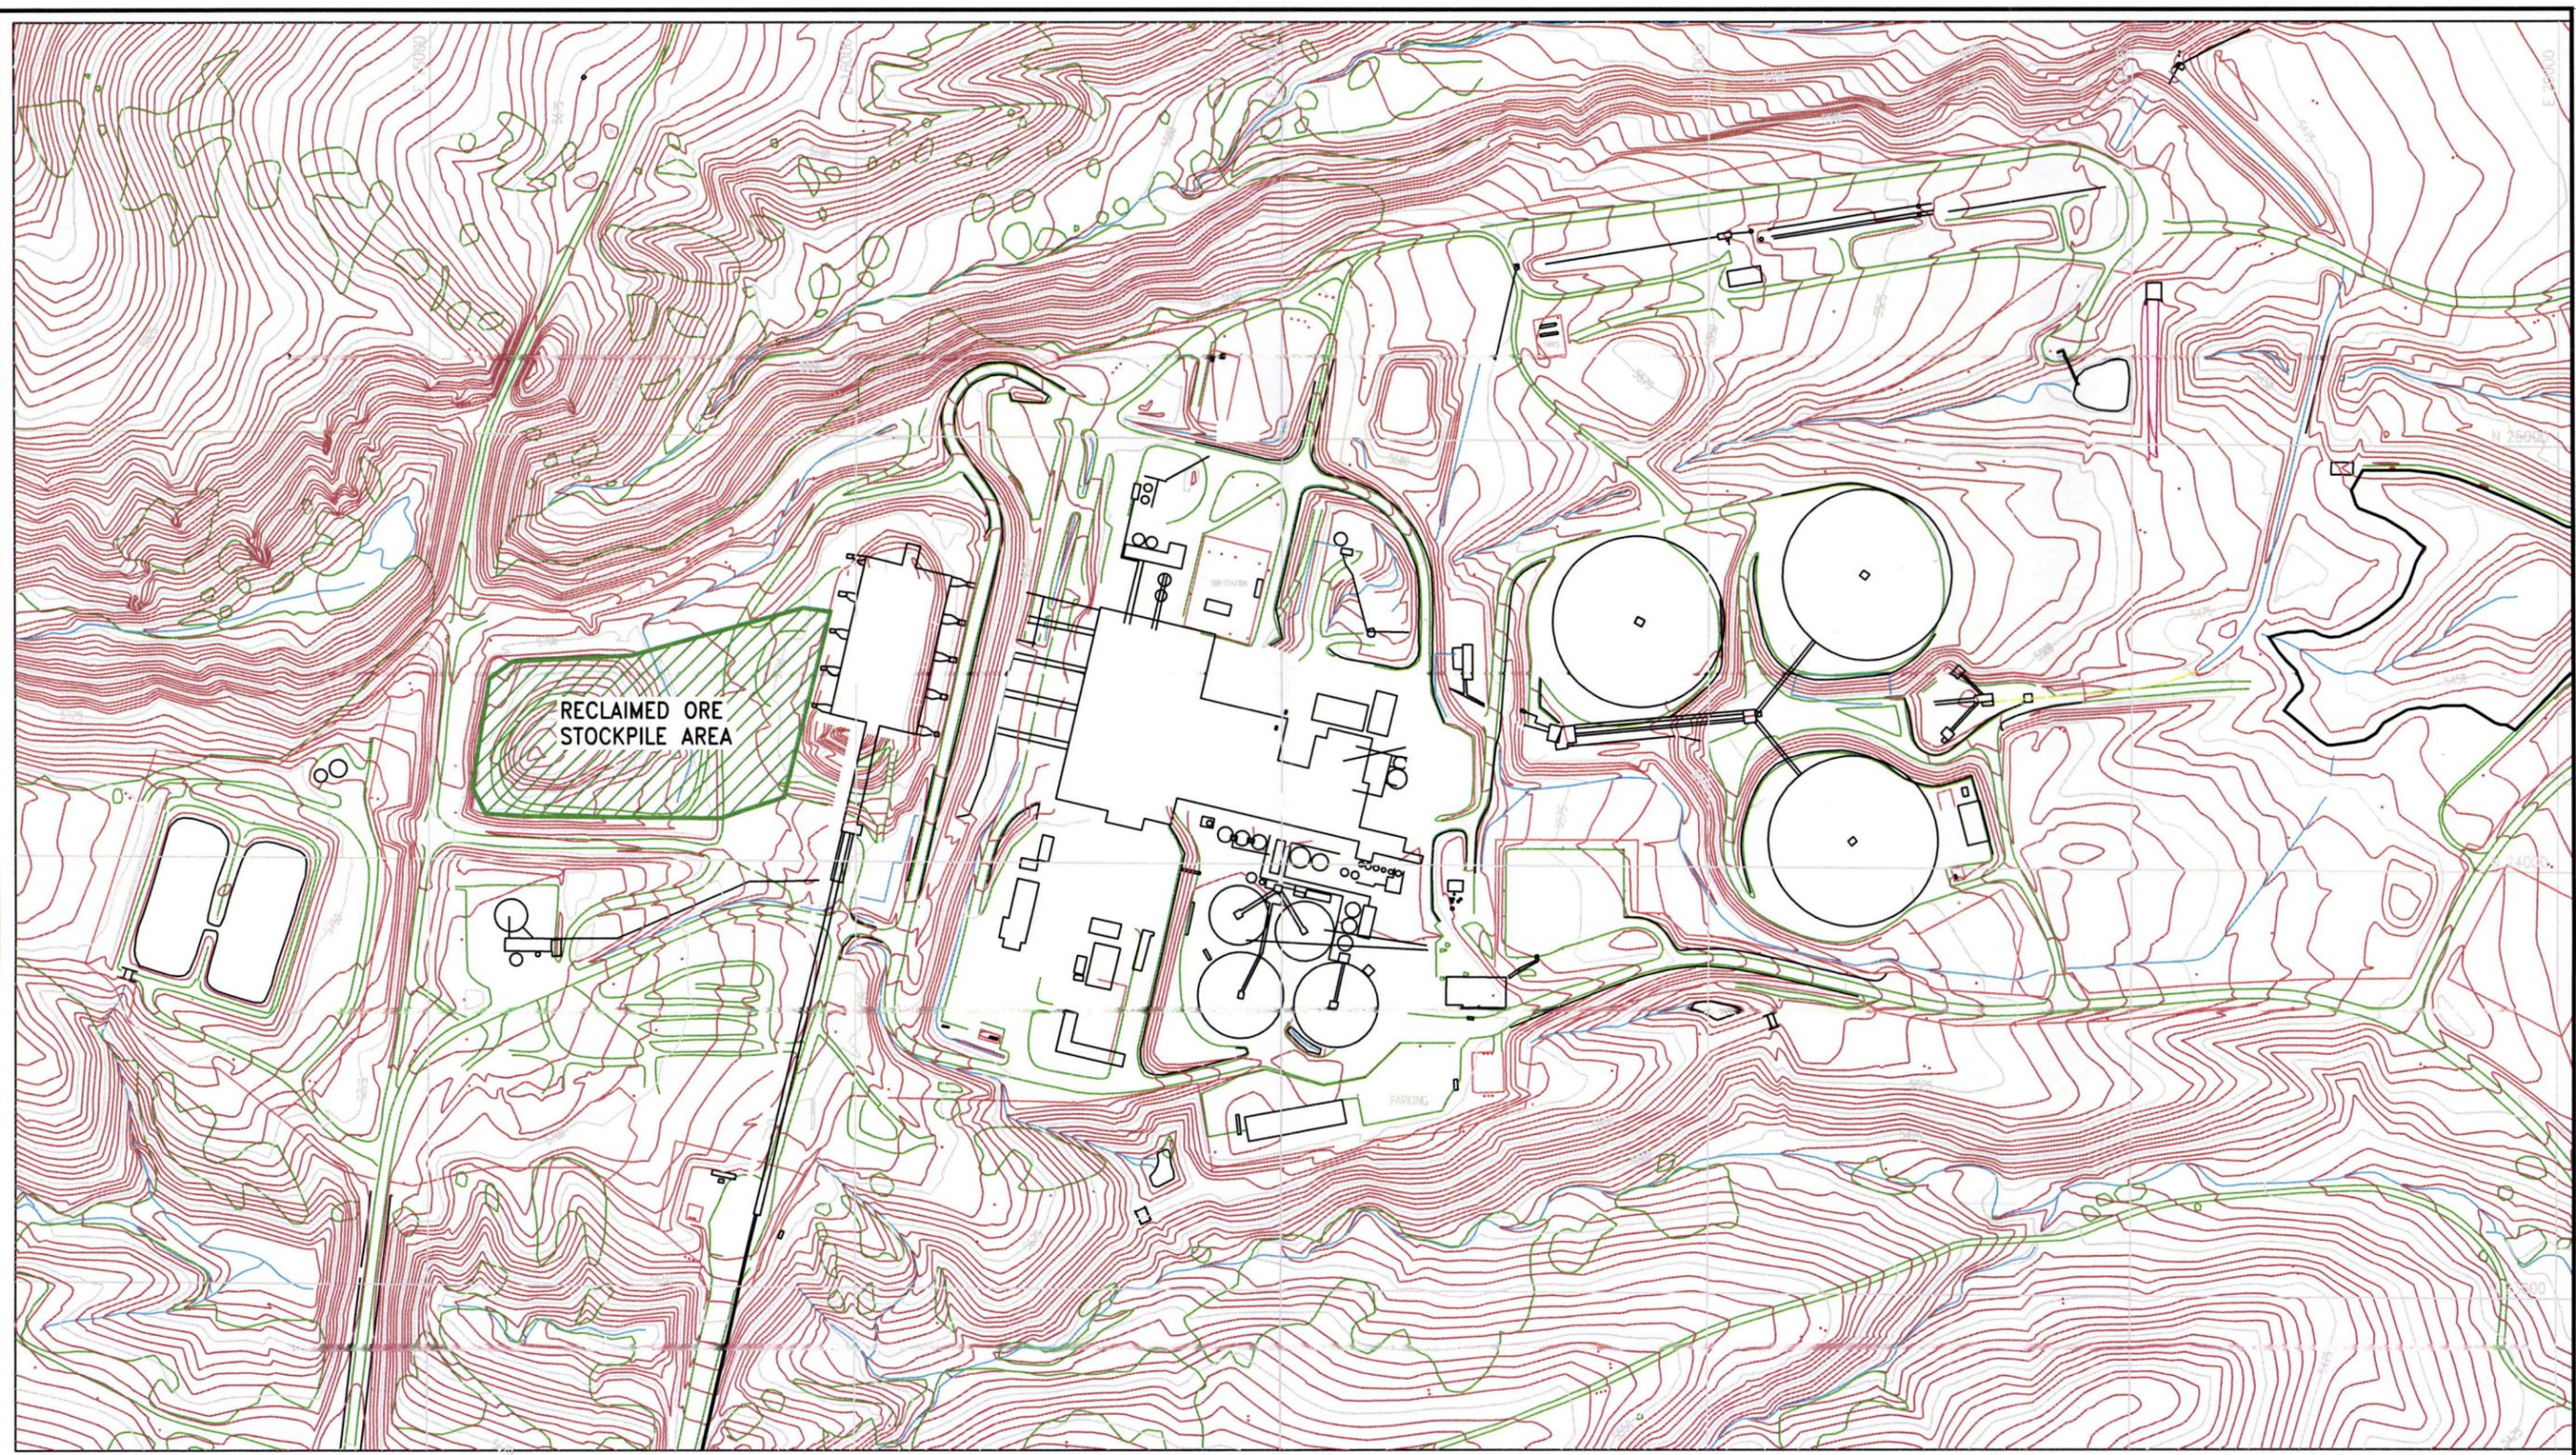

RECEIVED
 OCT 22 2003
 DIV. OF OIL, GAS & MINING

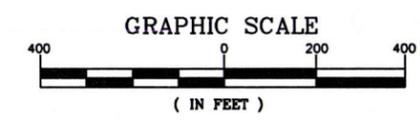

ENVIRONMENTAL AFFAIRS		KENNECOTT UTAH COPPER	
SCALE: 1" = 400'	DATE	FIGURE 2	
DESIGNED BY: VP	10/03	RECLAMATION PERFORMED AT COPPERTON CONCENTRATOR IN 2002	
DRAWN BY: MWC	10/03	Job No. ---	Dwg. No. 454-T-0063
CHECKED BY:			REV
PROJECT ENGINEER			
PROJECT MANAGER			